


Drawing Originator:
MWH

WAIHA STREET

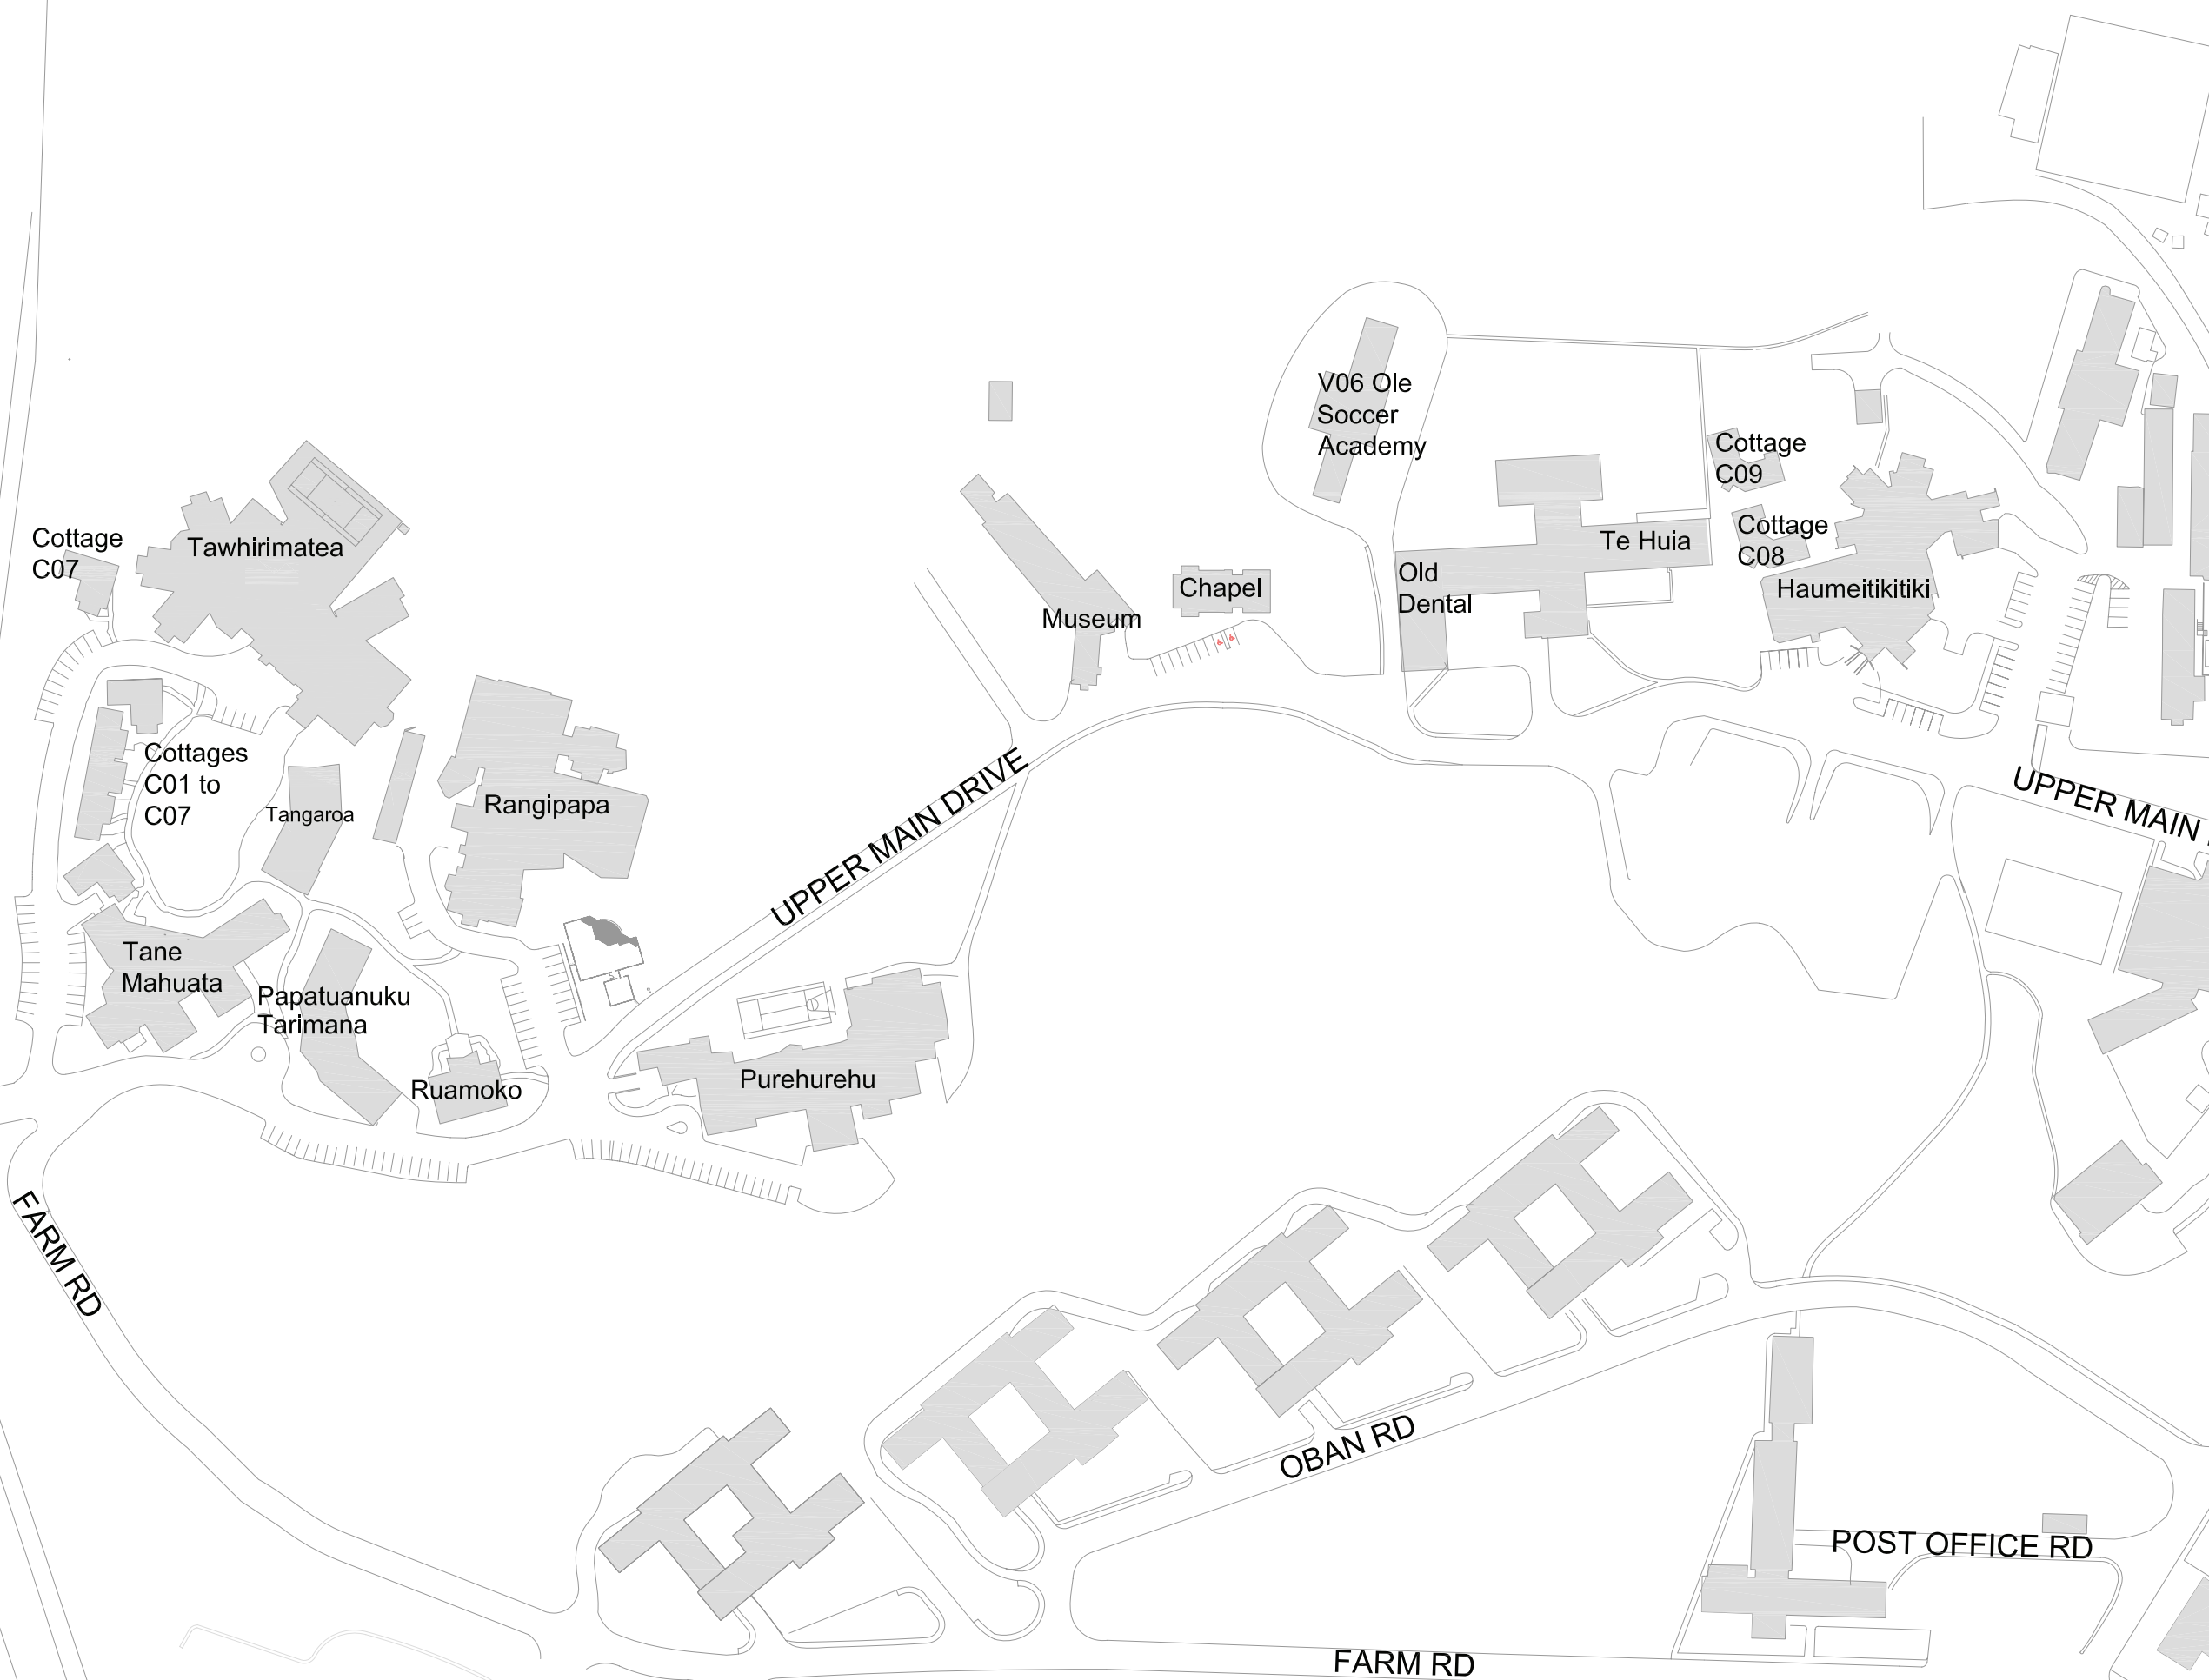

NOTES

LEGEND OF SERVICES

- SEWER
- STORMWATER
- WATER MAIN
- POWER-HV
- POWER-LV
- TELECOM
- TELECOM DUCT
- GAS
- UNDERGROUND DUCTS
- FIRE PROTECTION CABLE
- STREET LIGHTING CABLE
- STREET LIGHT
- DISTRIBUTION BOARD
- DISTRIBUTION BOARD WITH CELL
- SUBSTATION
- SWITCHBOARD
- TRANSFORMER
- GAS PRESSURE REDUCER
- GAS CONTROL VALVE
- FIRE HYDRANT
- WATER METER
- WATER SERVICE VALVE
- SUMP
- FIRE PROTECTION JUNCTION BOX
- FIRE PROTECTION MAIN JUNCTION BOX
- FIRE PROTECTION MULTIPLEXOR

Design			Approved For Construction
Drawn			
Des Check			Date
Dwg Check			Date
	Name	Date	

E	ADDED FILL & TIP SITES	PV	17.06.08
D	ADD DIESEL TANKS	IC	11.2.08
C	SEWER LINE ADDED M09	PV	5.11.07
B	BUILDING NAMES AND ADDRESSES UPDATED	P V	OCT 07
A	AS BUILT		1.02.07

No.	Revision	Approved	Date

Owner:



Status:
AS BUILT

Site:
KENEPURU HOSPITAL SITE

Building:
GROUPS / CARPARKS

Beims Site code:	Beims Building Code:	Floor Level:
PK	GRK	-

Title:
PORIRUA SITE BUILDING LAYOUT

Discipline:
CIVIL

Scale at Full Size:	Scale at Half Size:
NTS	NTS

Digital File Name:	Rev.
PKCSK-C001.DWG	E
Drawing No.	
PK GRK - C SITE BASE DATA	